



Red-lined copy

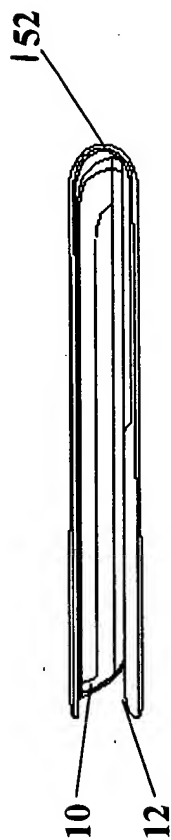


Fig. 7

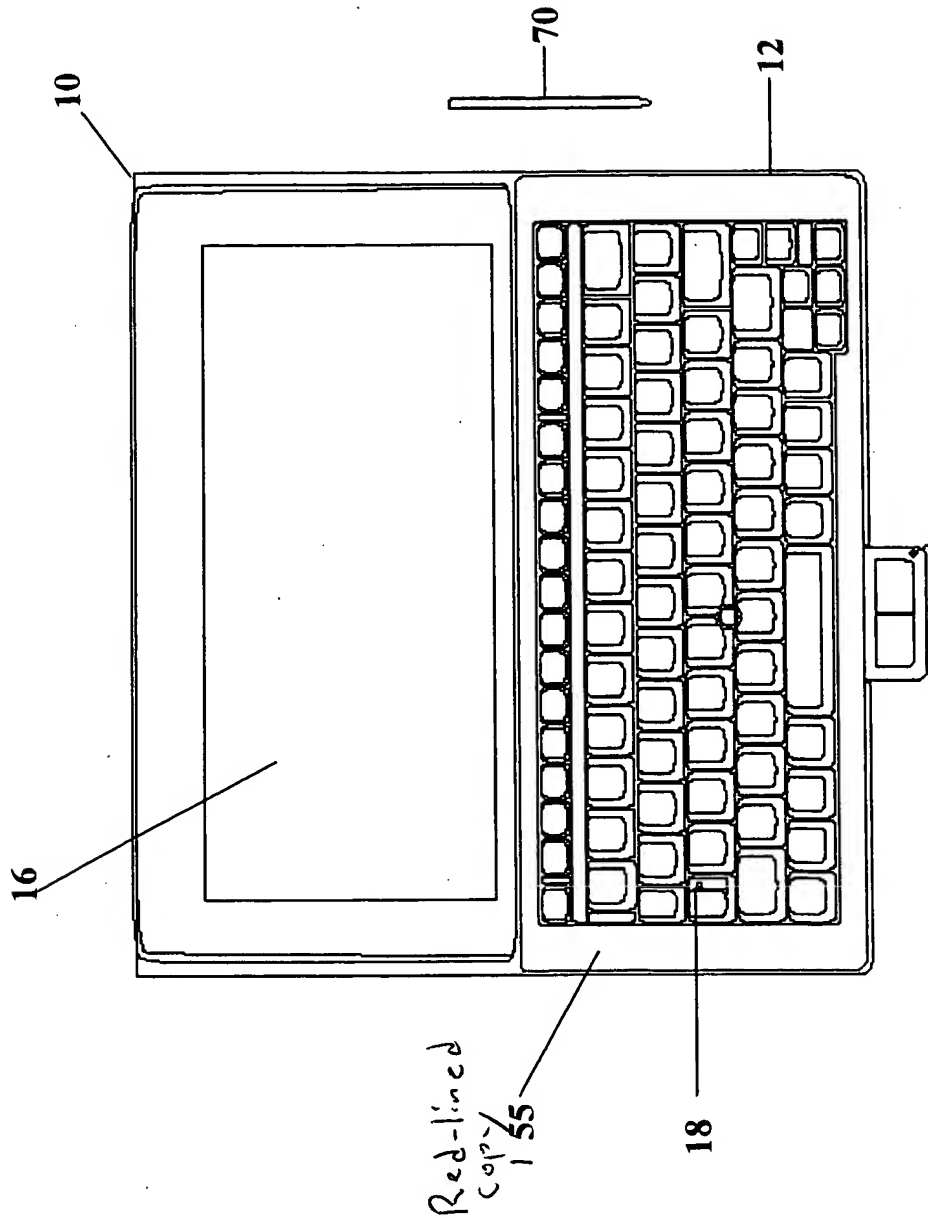


Fig. 8(a)



Red-lined copy

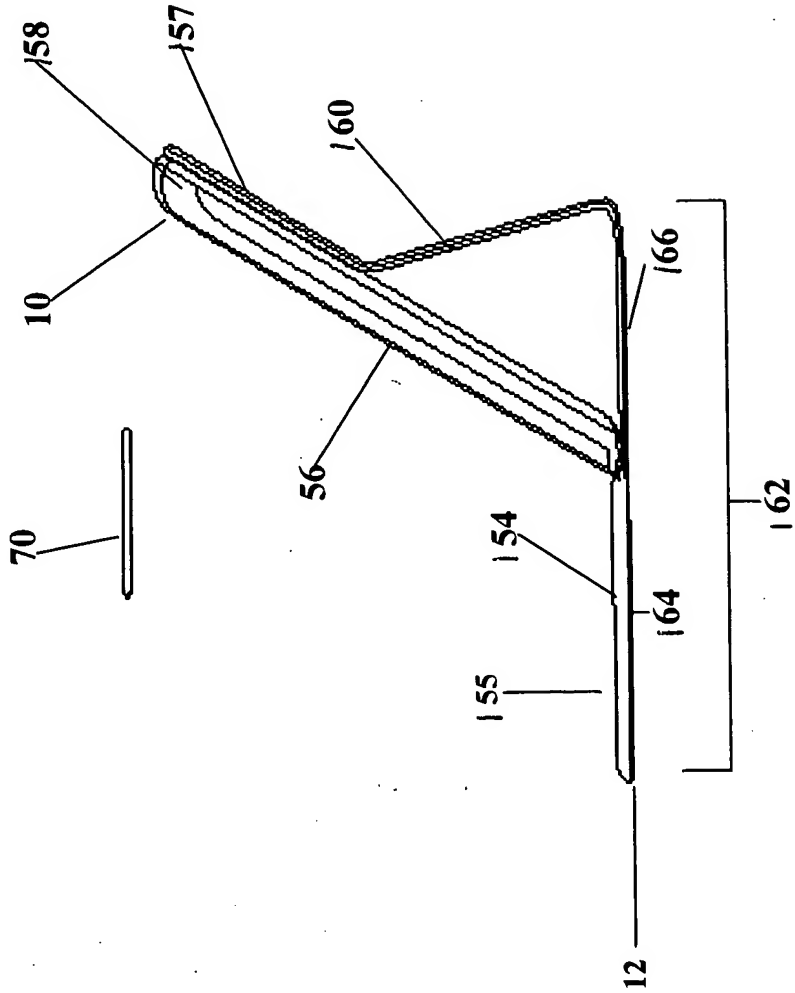


Fig. 8(b)



Red-Lined (q2)

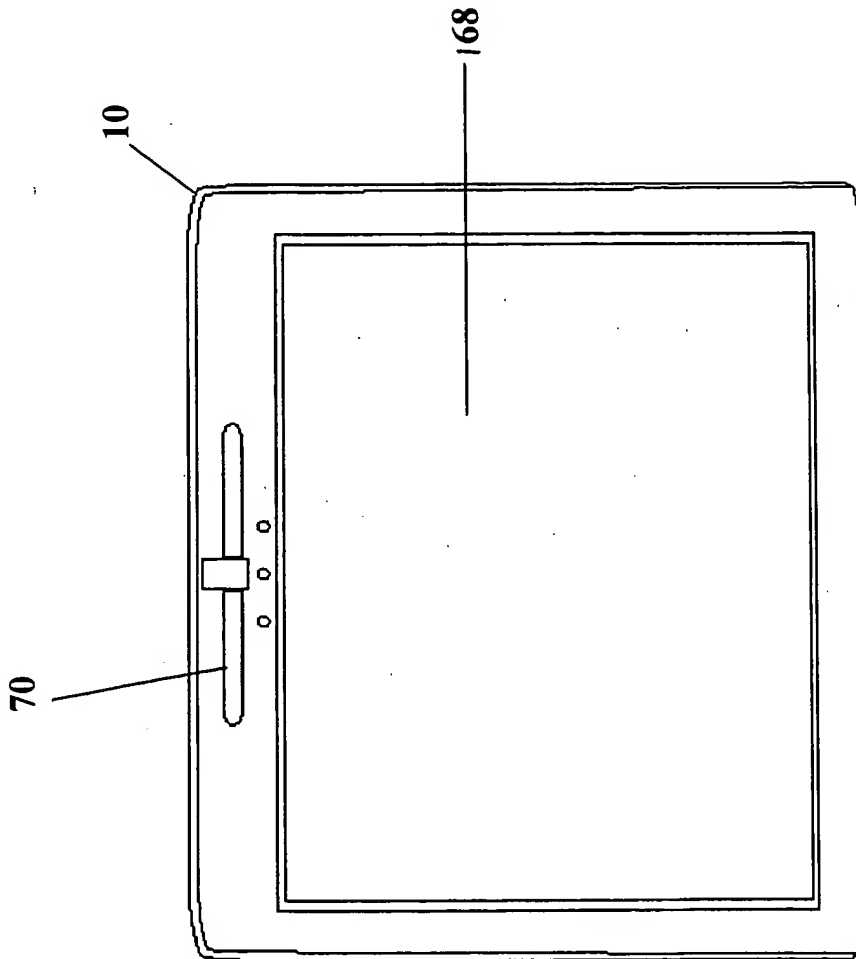


Fig. 9(a)

Title: Portable Computer Usable in ...

Attorney Name: Charanjit Brahma

Tel.: (213) 488-7100 Docket No.: 81087-276982

Sheet 19 of 33



*Red-lined copy*

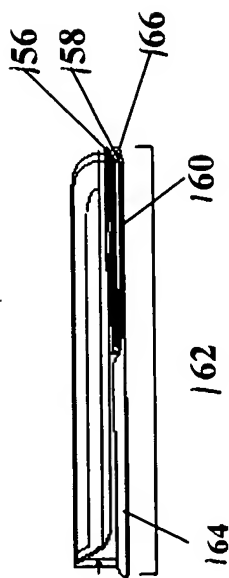


Fig. 9(b)